

I approve this plan as drawn and authorize Fisher Group, LLC to construct. All modifications or changes to these plans shall be made in writing and shall be the responsibility of Fisher Group, LLC. No other person shall be authorized to modify or use them.

APPROVED BY:

BRENNINGMEYER GRAHAM
 RESIDENCE
 3225 PRINCE WILLIAM DRIVE
 MANTUA, VIRGINIA 22081

CLIENT:

TITLE:

FISHER GROUP LLC
 Design
 Build
 Renovate


DATE: 06/30/16

DRAWING NUMBER:

AS BUILT DRAWING

Scale: 1/4" = 1'-0"

As Built Plan
 30 June 2016

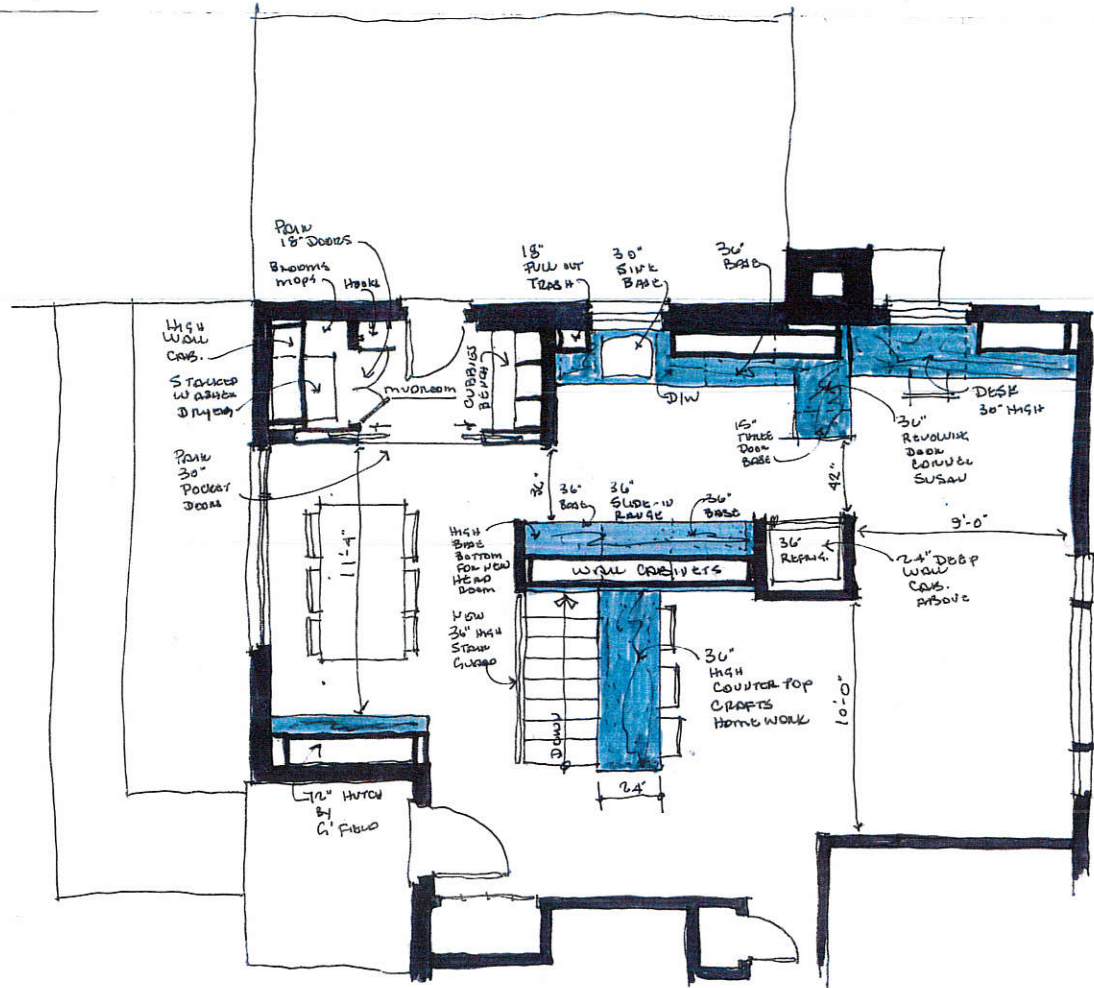


A

DATE: 07/10/16
 CLIENT: BRENNINGMEYER GRAHAM RESIDENCE
 3225 PRINCE WILLIAM DRIVE MANTUA, VIRGINIA 22031
 TITLE: AS BUILT DRAWING
 SCALE: 1/4" = 1'-0"
 APPROVED BY: [Signature]




A

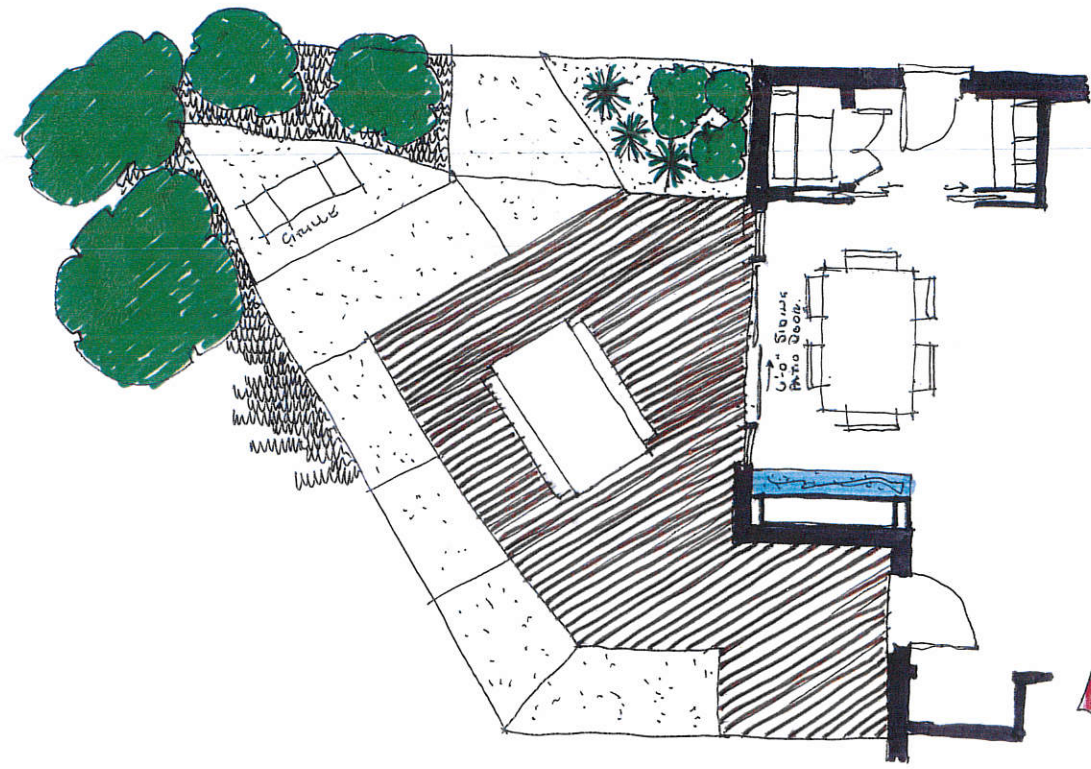

A1
Deck

DECK COMPATIBLE WITH EACH OPTION PLAN.


DATE: 07/10/16
 CLIENT: BRENNINGMEYER GRAHAM RESIDENCE
 3225 PRINCE WILLIAM DRIVE MANTUA, VIRGINIA 22031
 TITLE: AS BUILT DRAWING
 SCALE: 1/4" = 1'-0"
 APPROVED BY: [Signature]

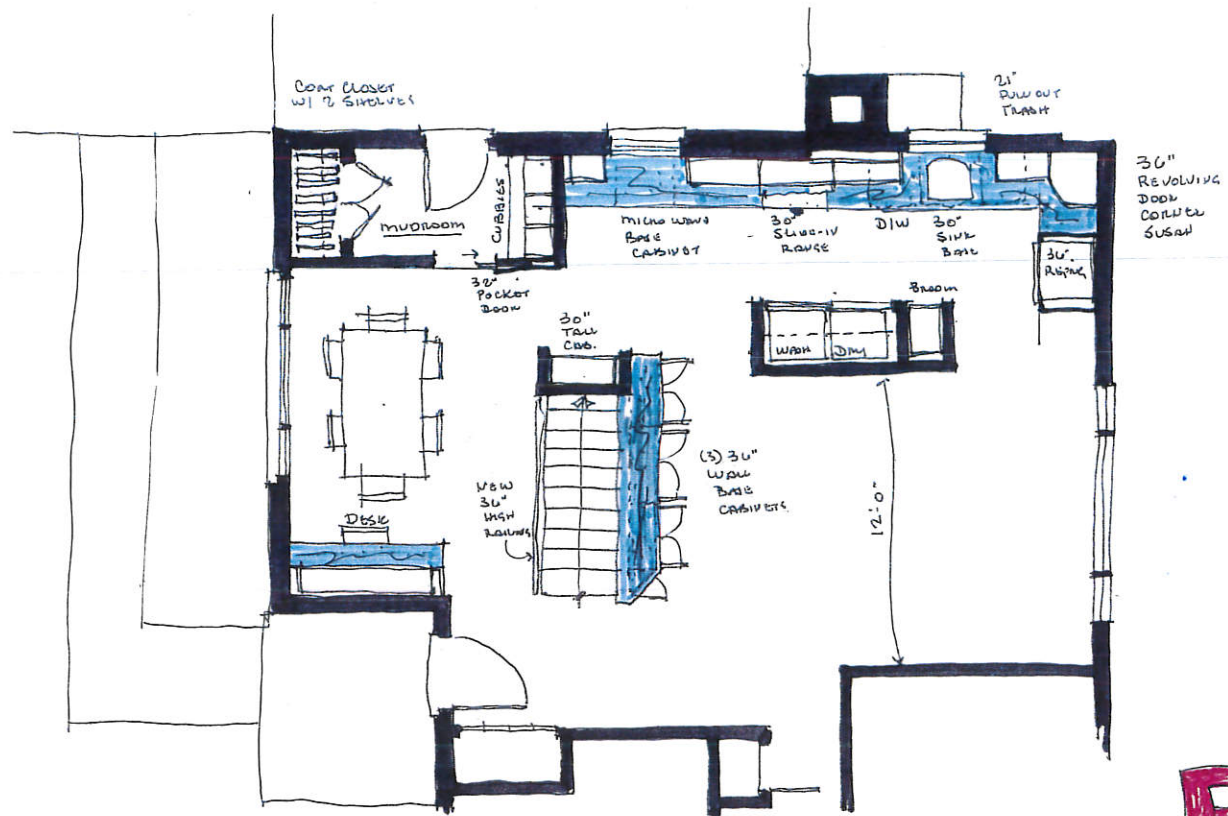


B



C

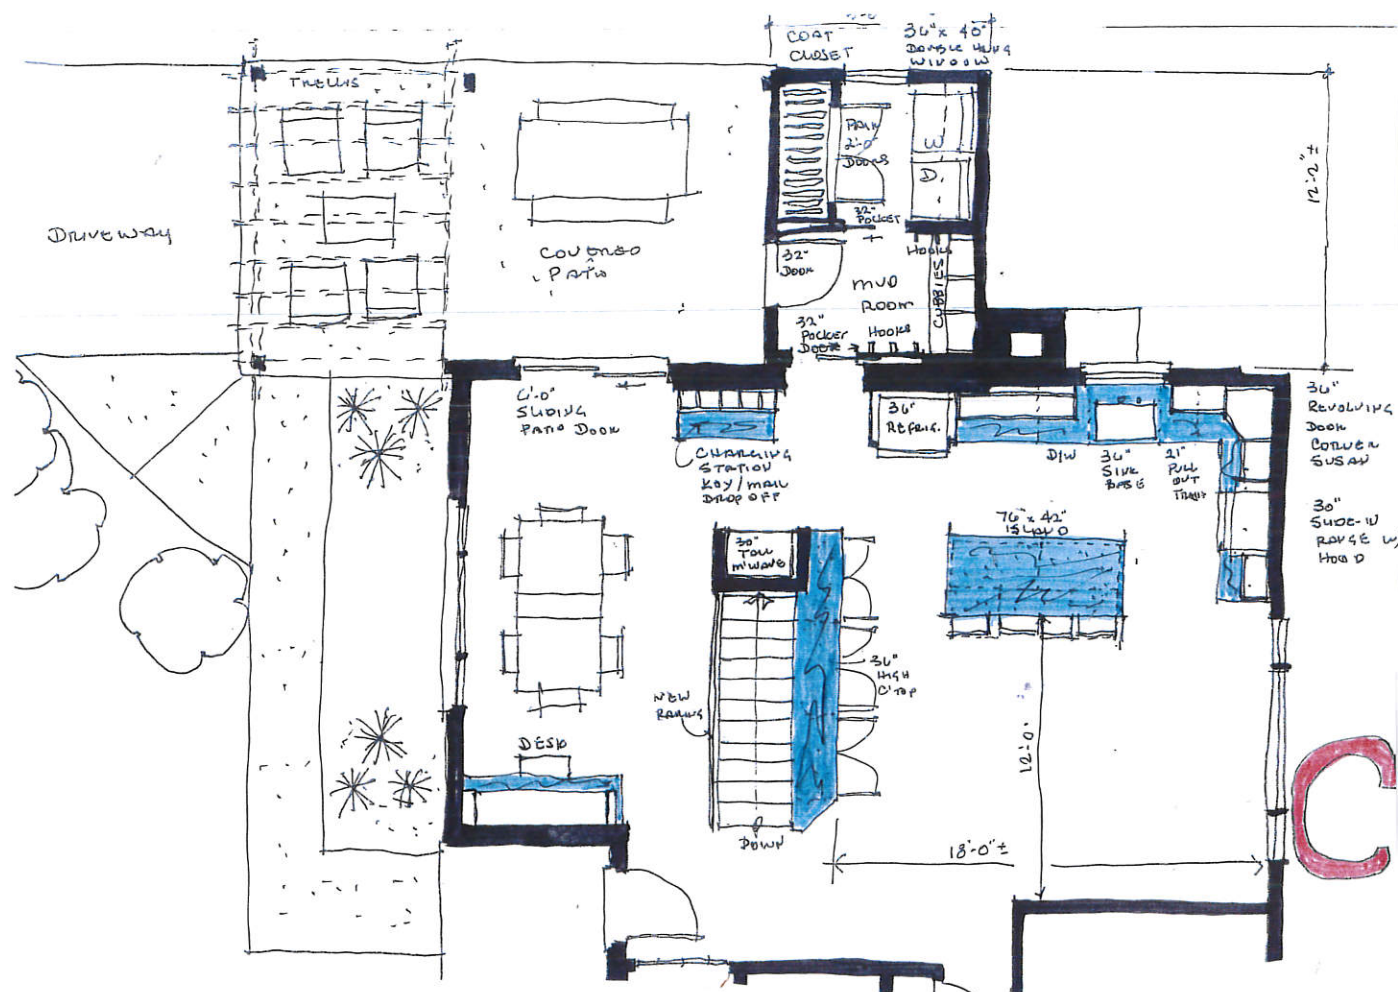

C

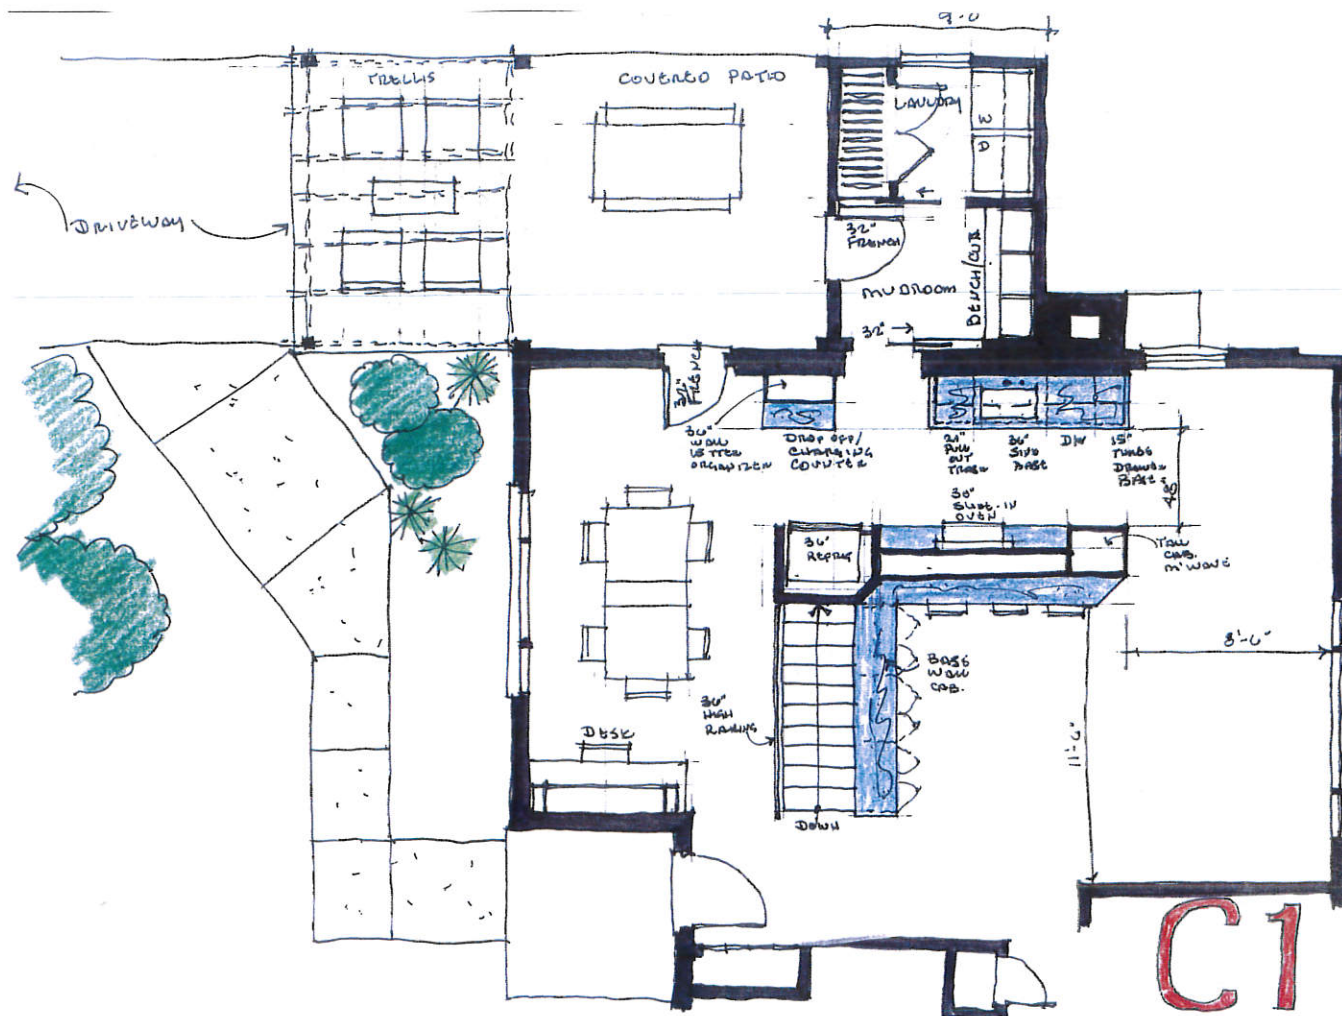

C1